



7/23/25
DENSITY LOCATIONS



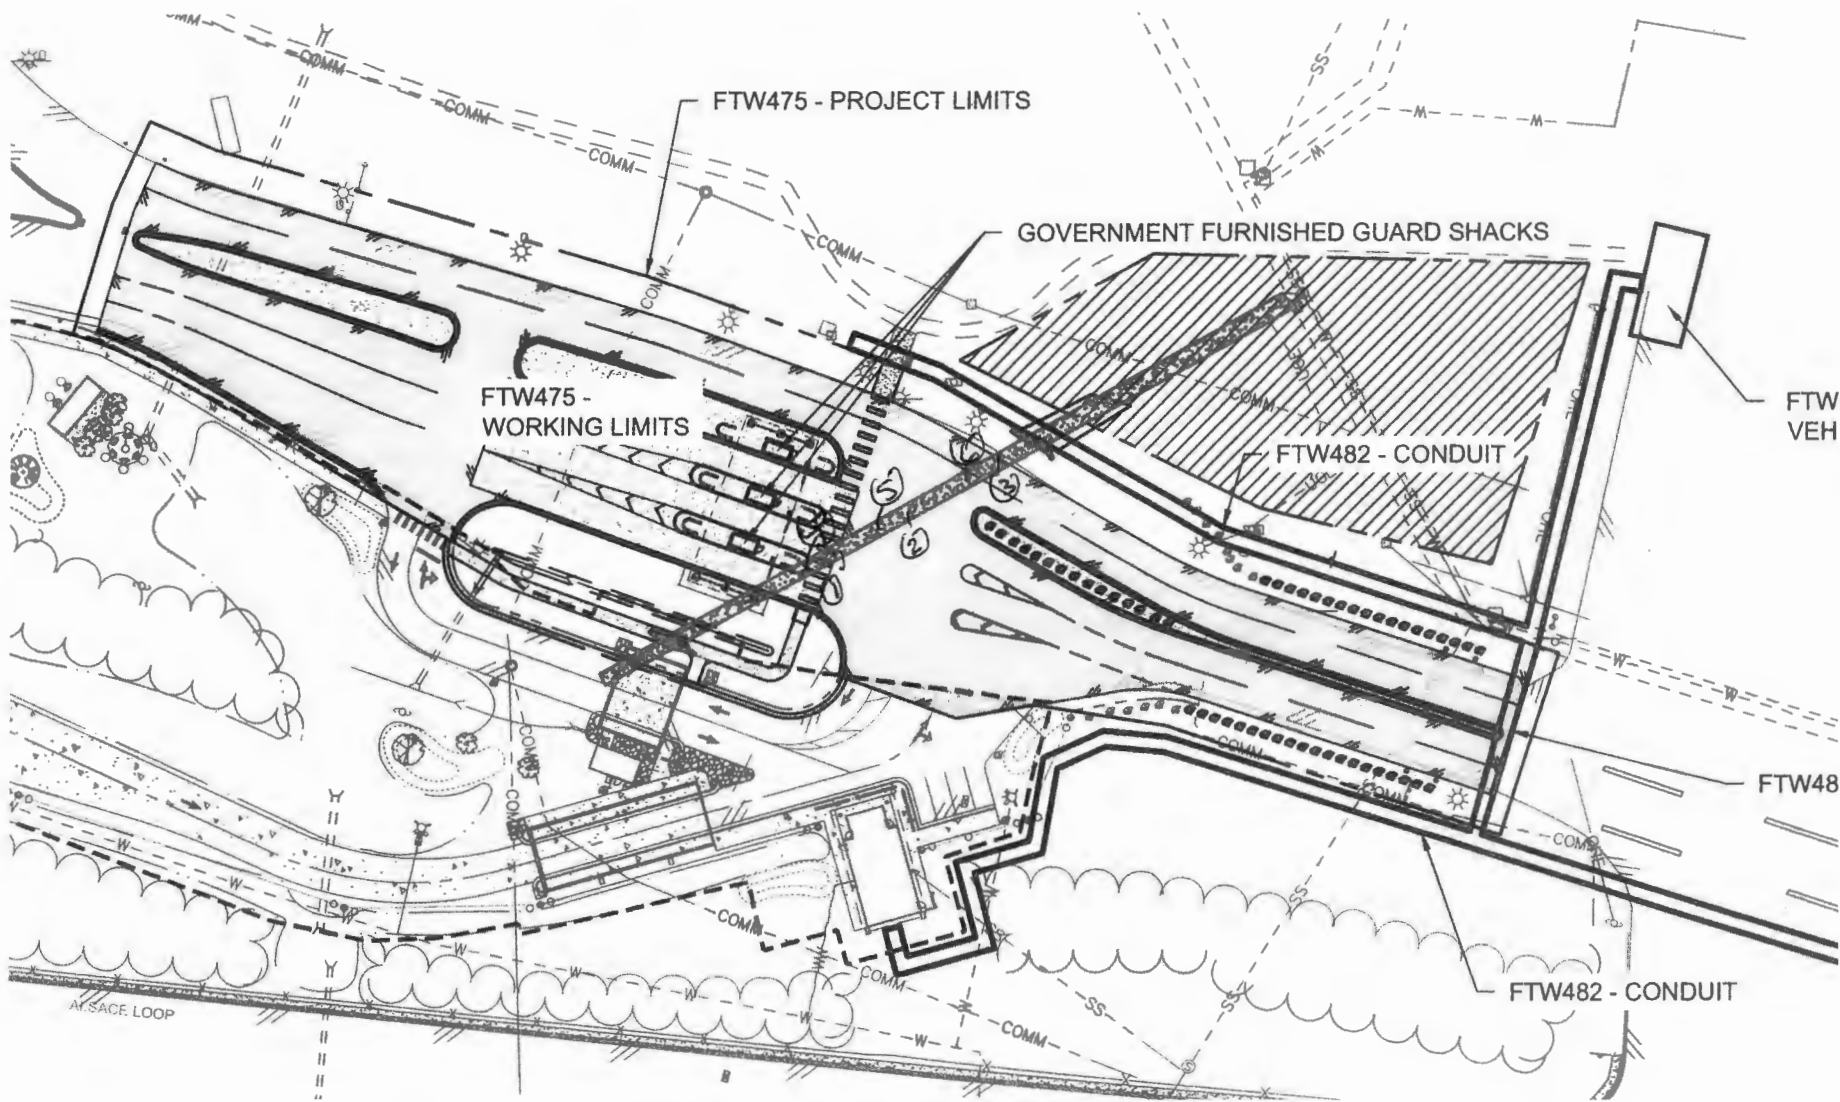

US Army Corps
of Engineers

<p>U.S. ARMY CORPS OF ENGINEERS REPAIR FRONT GUARDERS BARRIS & BARRIS CPW-2288-23 GAFFNEY GATE CONSTRUCTION PHASING GAFFNEY GATE</p>	<p>DESIGNED BY: _____ DRAWN BY: _____ CHECKED BY: _____ SUBMITTED BY: _____ S. NAME: _____ JOB NO.: _____ FILE NUMBER: _____ JOB ID: FTW475-02-048</p>
<p>REVISION DATE: _____ MAX. SIZE: _____ SUBMIT FOR NO: _____ CONTRACT NO: _____ DATE: _____ SCALE: _____ DATE: _____</p>	<p>MARK: _____ DESCRIPTION: _____ DATE: _____</p>

SHEET ID
G-102

AWWG © _____
AWARD

RECORD SET
4/24/2025 11:48 AM
11